



CHARLES D FLAYHAN ASSOCIATES INC
880 CANAL STREET STAMFORD CT 06902
203 348-4300

DATE	ISSUED TO	PR	TR
12-7-84	PORT AUTHORITY FOR APPROVAL CIVILS CORP. FILE 8105 C.P.C. FOR RECORD	10	1
1-10-85	PORT AUTHORITY FOR APPROVAL CIVILS CORP. FOR INFORMATION C.P.C. FOR RECORD	10	1
5-9-85	PORT AUTHORITY "AS BUILT"	0	2

AS-BUILT DRAWING

DATE: 5/22/86
INSPECTOR: [Signature]

NO	DATE	REVISION	BY
1	4-20-85	GENERAL REVISION TO CONFORM TO AS BUILT CONDITIONS	J.F.F.
2	1-11-85	REVISED DETAIL'S TO CONFORM WITH PORT AUTHORITY REQUEST	J.F.F.

CANTOR, FITZGERALD SECURITIES CORP.
105th FLOOR
ONE WORLD TRADE CENTER, NEW YORK N.Y.

NEW CORPORATE BOND TRADING ROOM
DEMOLITION & CONSTRUCTION PLAN & DETAILS

PROJECT NO 1357A	SCALE 1/4" = 1'-0"
DRAWN BY J.F.F.	CHECKED BY
DATE 12-6-84	

DRAWING NO **105F**


3

LEGEND	
○	SPACE NUMBER
○	DOOR NUMBER
≡	EXISTING NO CHANGE
⊕	ELEVATION SYMBOL: UPPER NUMBER DENOTES ELEVATION NUMBER, LOWER NUMBER DENOTES SHEET NUMBER
⊖	DETAIL SYMBOL: UPPER NUMBER DENOTES DETAIL NUMBER, LOWER NUMBER DENOTES SHEET NUMBER
≡	EXISTING CONSTRUCTION (NO CHANGE)
----	EXISTING PARTITION OR CONSTRUCTION TO BE REMOVED
①	NEW PARTITION WITH GYPSUM BOARD TO 8' ABOVE HUNG S.C. SEE DETAIL THIS SHEET
②	NEW 2'-0" X 2'-0" RAISED ACCESS FLOOR @ 2' ABOVE CONCRETE SLAB. SEE DRAWING 105F-1 FOR SPECIFICATIONS
③	INDICATES FLOOR ELEVATION ABOVE CONCRETE FLOOR

GENERAL NOTES


REFER TO DRAWING 105F-1 FOR ADDITIONAL GENERAL NOTES & CONSTRUCTION SPECIFICATIONS

AREA SHOWN ON THIS DRAWING

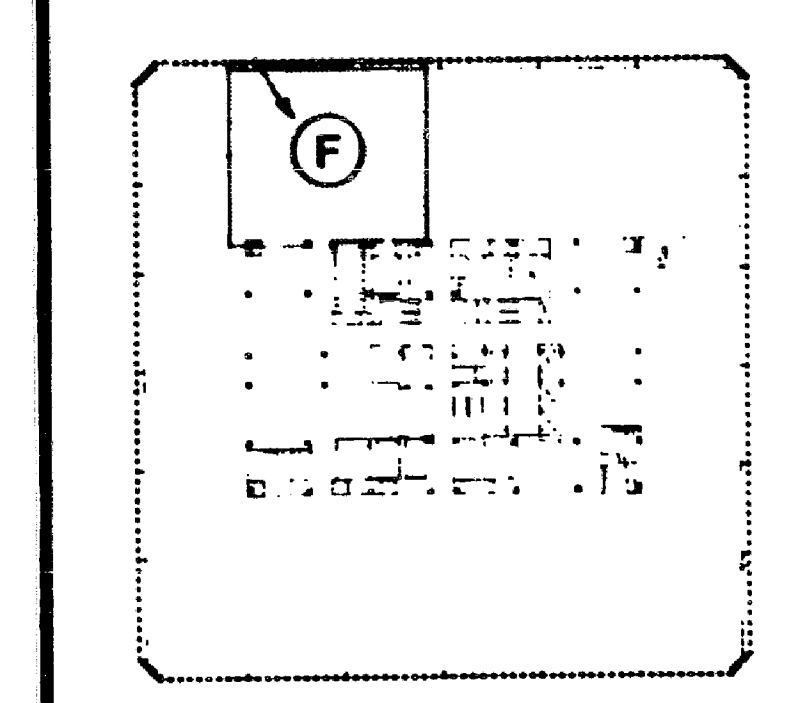


KEY PLAN

PHASE **F**
TAA NO. 3104
AS BUILT DWG.
5-1-85

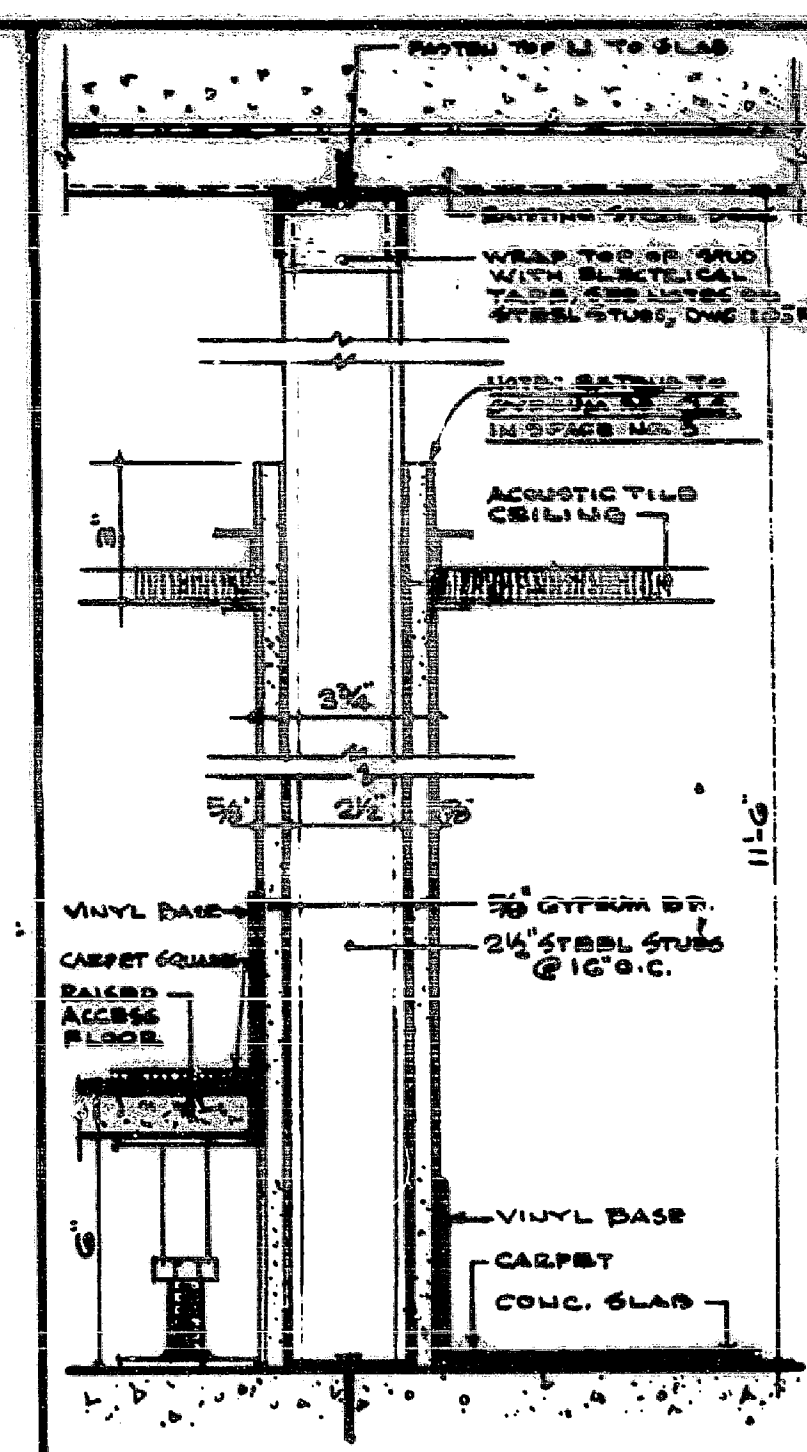

① NON RATED PARTITION
W.T.C. TYPE 14

NOTES
1. NOTCH RAISED FLOOR PANELS 2"x12" AT WALL FOR WIRE ACCESS

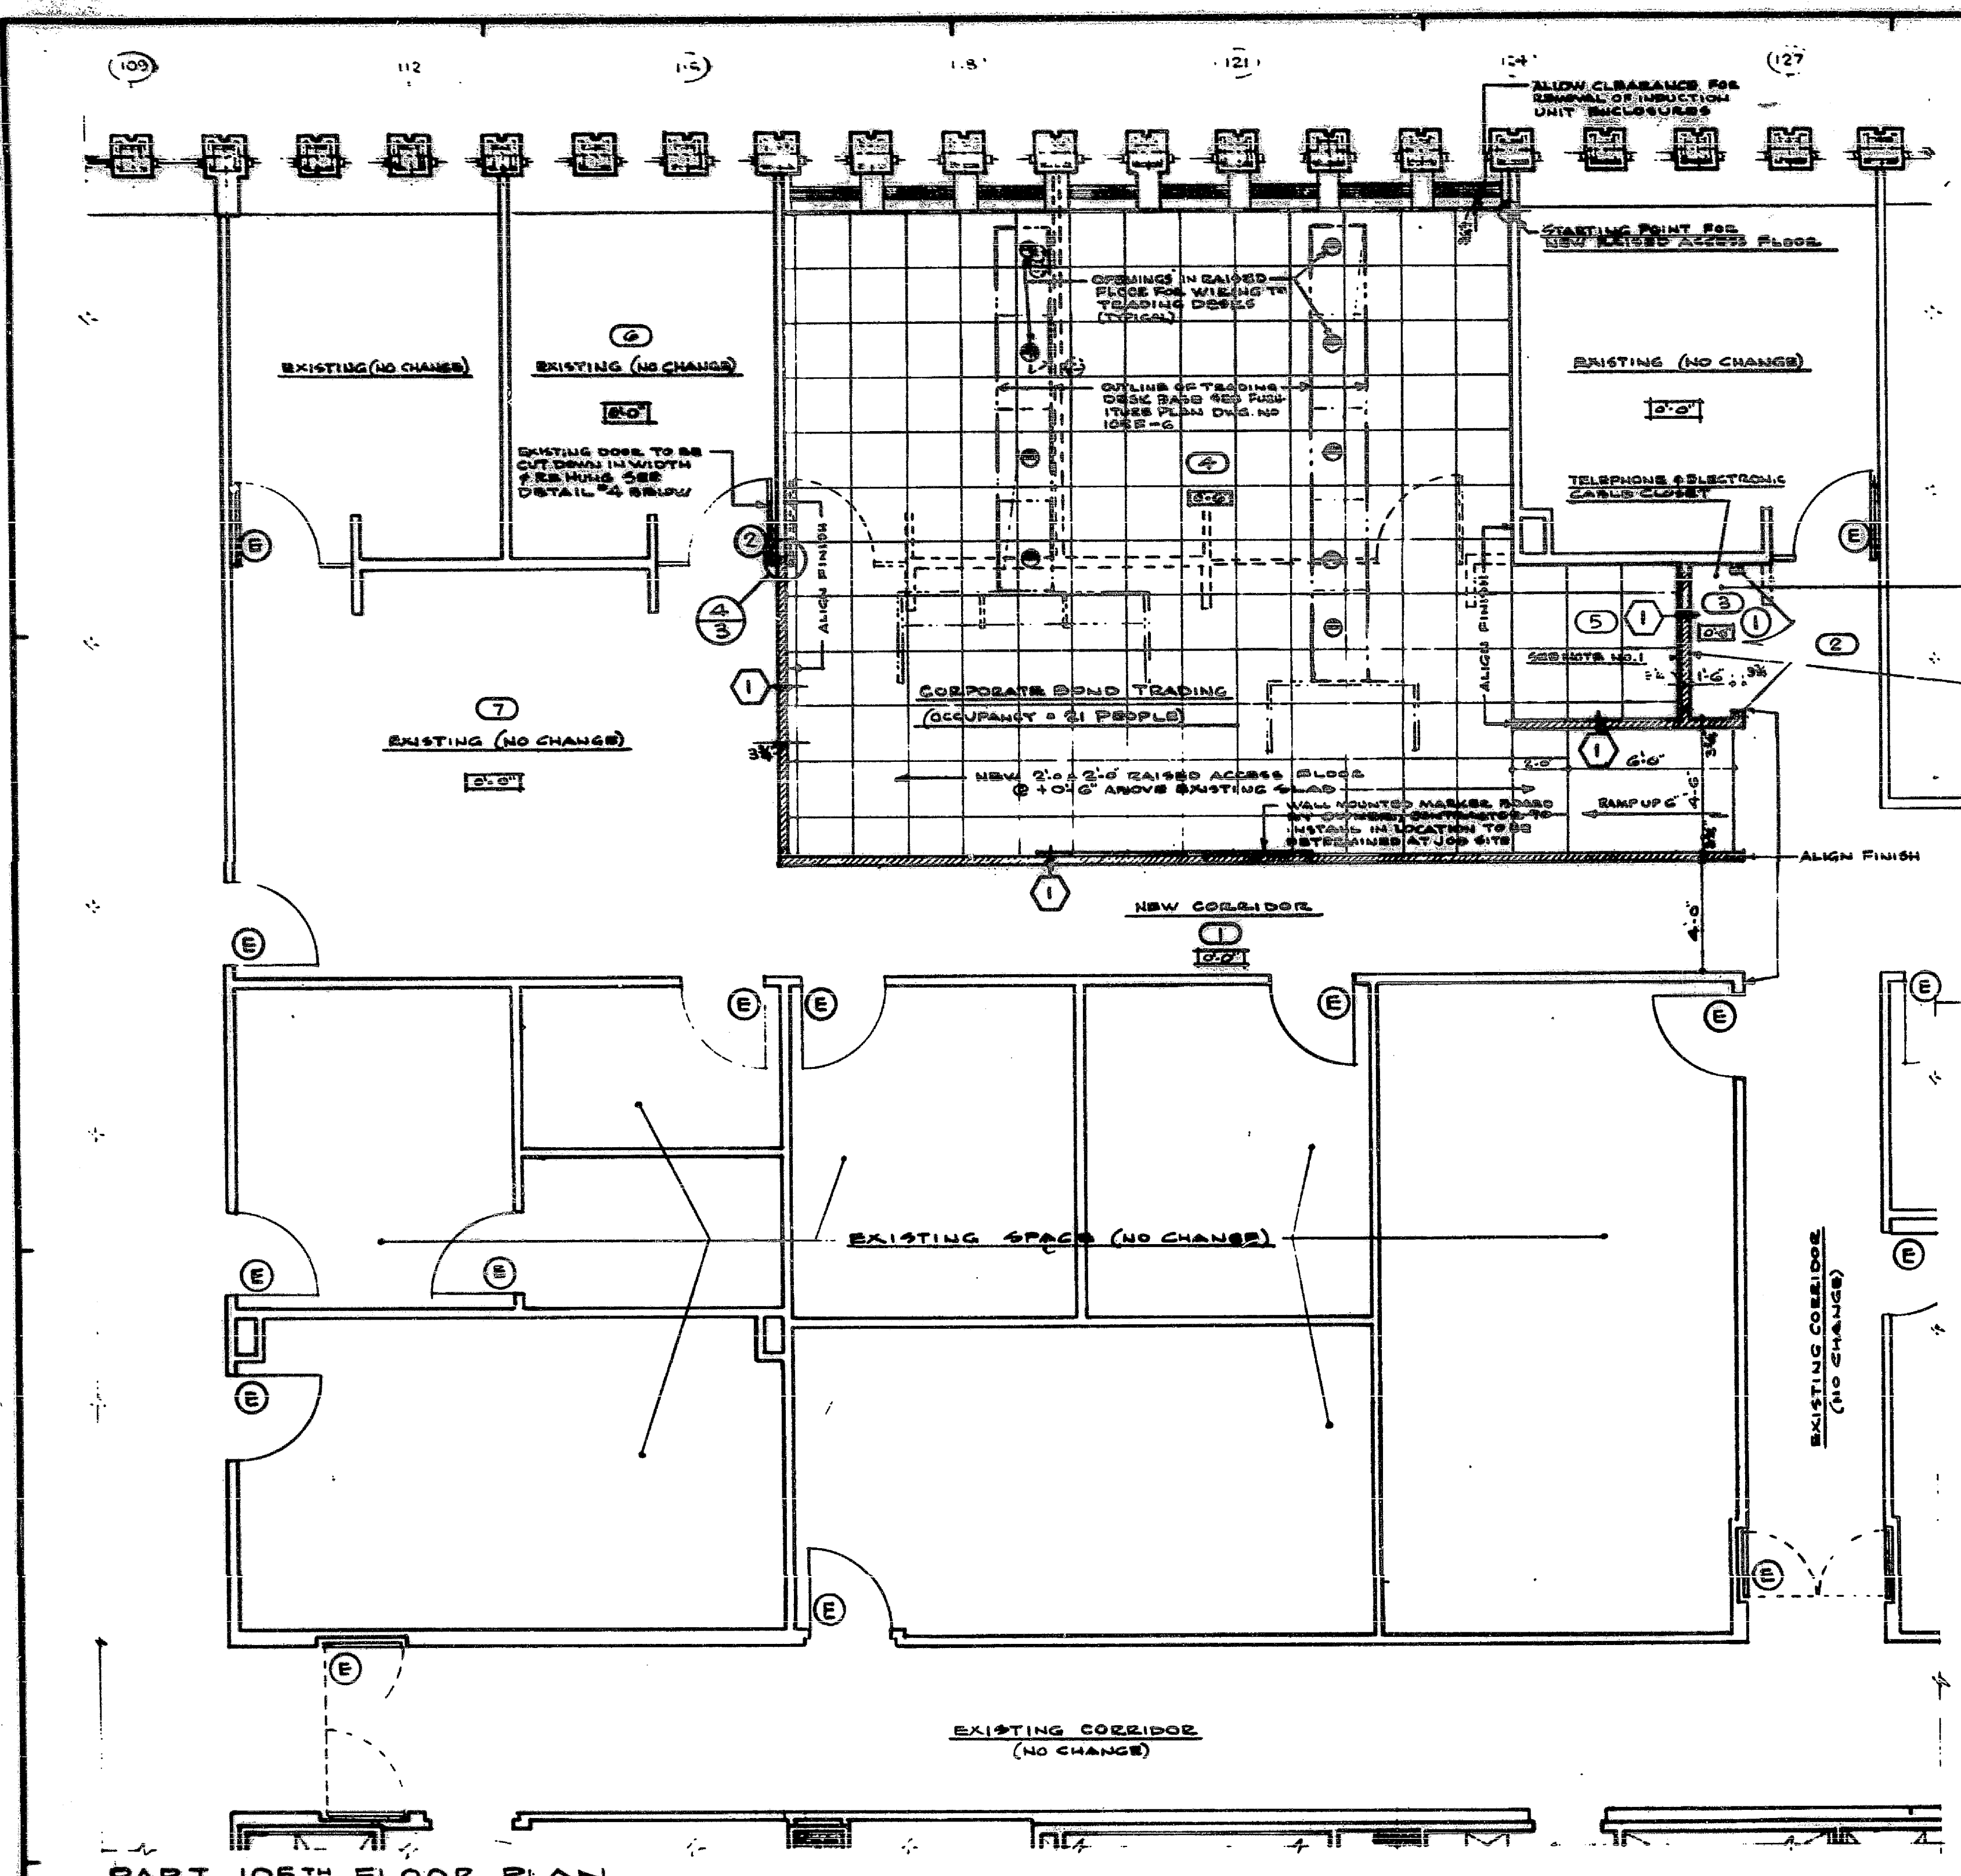

PART 105TH FLOOR PLAN
5/22/86

ELEVATIONS & DETAILS FOR DOOR NO. 1

1 HEAD @ 5'-10"

2 JAMB @ 5'-10"

3 WEST PARTITION SPACE NO. 2 ONLY @ 5'-10"

4 JAMB SECTION AT DOOR NO. 2 @ 5'-10"

HARDWARE
HINGES: 2 PAIR 4"x4"x1/2" PLUG STANDARD BUTTS
LATCHES: MATCH EXIST. IN THIS AREA
FLUSHES: TOP & BOTTOM, BUILDING STANDARD

DRAWING NO. 105F
CANTOR, FITZGERALD SECURITIES CORP.
NEW CORPORATE BOND TRADING ROOM
105-F-3
5/22/86

DRAWING NUMBER

DATE: 5/22/86

DRAWING NUMBER